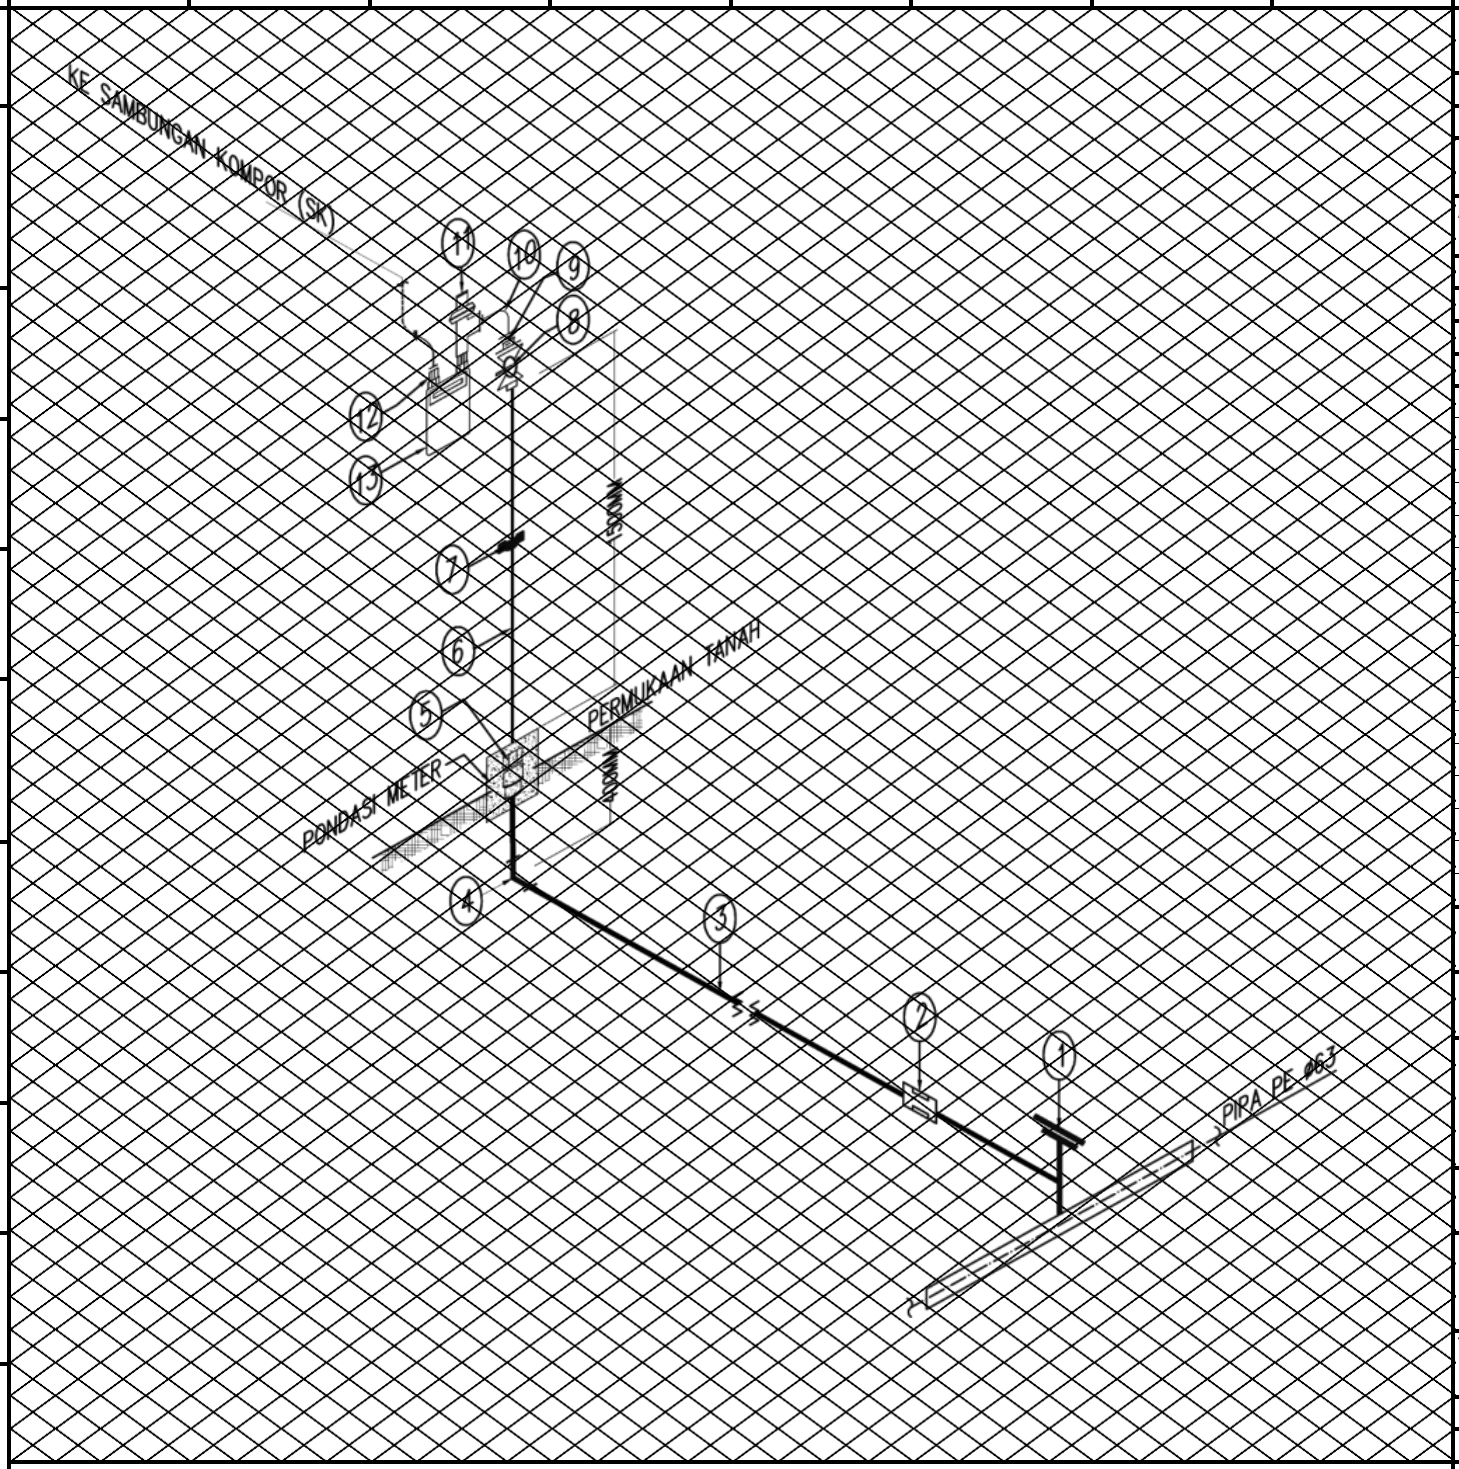

ISOMETRIK SR

NO REG	
NO METER	
NAMA	
ALAMAT	
PADUKUHAN	RT / RW
KELURAHAN	

BILL OF MATERIAL SR

No	Description	Qty	
1	Tapping Sadle 63 x 20 mm	1	Pcs
2	Coupler 20 mm		Pcs
3	Pipa PE 20 mm		M
4	Elbow 90 x 20 mm		Pcs
5	Transition Fitting	1	Pcs
6	Pondasi Tiang SR	1	Pcs
7	Pipa Galvanize 3/4"	1.5	M
8	Klem Pipa	1	Pcs
9	Ball Valve 3/4"	1	Pcs
10	Double Nipple 3/4"	1	Pcs
11	Long Elbow 3/4"	1	Pcs
12	Regulator Service	1	Pcs
13	Coupling MGRT	2	Pcs
14	Meter Gas Rumah Tangga	1	Pcs
15	Cassing 1"		M
16	Sealtape		Pcs
1			

Rev	Date	KSM	CGP
		Dibuat	Disetujui

PERTAMINA GAS NEGARA — PT. PERUSAHAAN GAS NEGARA (Persero) Tbk.

PT Kian Santang Muliatama Tbk — PT. Kian Santang Muliatama

Project :
Pembangunan Jaringan Gas Rumah Tangga Area Sleman

Title :
As Built Drawing Sambungan Rumah (SR)

Drawing No	Scale	Date	Rev
0	NTS		1
Sheet No 1 Of 1			